

IF THIS DRAWING IS NOT 24" x 36" IT IS A REDUCED PRINT SCALE ACCORDINGLY

JUSTIN PC ARCHITECTS
205 LEXINGTON AVE
NEW YORK, NY 10005
TEL (212) 689 9550

JOHN C. WESTRICK & ASSOCIATES
CONSULTING ENGINEERS
2110 MAPLE AVE. SOUTH PLAINFIELD, N.J.
07080 201 581-4170

DATE	ISSUED TO	PR.	TR.
3/22/91	RET. AUTHORITY FOR APPROVAL	10	1
3/22/91	CFSC FOR RECORD CONTRACTORS FOR BIDDING	4	4
4/19/91	CFSC	1	1
5-8-91	P.A. FOR APPROVAL	10	-
5-22-91	CDG MESTEL	8	1
6-7-91	CFSC	1	1
10-21-91	P.A. "AS BUILT DRAWING"	-	1

AS BUILT DRAWING
8-6-91
DATE
JUSTIN PC ARCHITECTS

8-6-91	REVISED TO SHOW AS BUILT CONDITIONS	JCF
NO DATE	REVISION	BY

CANTOR, FITZGERALD SECURITIES CORP.
105TH FLOOR
ONE WORLD TRADE CENTER, NEW YORK, N.Y.


PROPOSED NEW TRADING ROOM FOR INVESTMENT STRATEGIES
POWER & TELEPHONE PLAN

PROJECT NO 706
SCALE 1/4" = 1'-0"
DRAWN BY J.F.P.
CHECKED BY J.F.P.
DATE MARCH 20, 1991


DRAWING NO
105P
8

SYMBOL	DESCRIPTION	REMARKS
1	LOW VOLTAGE SIGNAL RECEPTACLE FOR PRINTERS	SPACE NO. 11 + 7
2	OPENING FOR L.V. SIGNAL CABLE TO GUY MOUNT TOP	PROVIDE FLOOR HEAD OR WIRING GEOMETRIC IN RAISED ACCESS FLOOR SPACE NO. 8 + 7
3	FLOOR GEOMETRIC FOR SIGNAL CABLE TO PRINTERS	SPACE NO. 11
4	RECEPTACLE FOR SIGNAL CABLE TO FAX MACHINES	SPACE NO. 11

SYMBOL	DESCRIPTION
1	EXISTING WALL DUFF SPACE
2	EXISTING WALL DUFF SPACE (NO CHANGE)
3	EX. WALL OR FLOOR POWER RECEPTACLE TO BE REMOVED & CAPPED
4	EX. DWG. NO. 105 P-4 FOR LOCATION
5	EX. WALL OR FLOOR MOUNTED TELEPHONE OUTLET TO BE REMOVED & CAPPED
6	EX. DWG. NO. 105 P-4 FOR LOCATION
7	NEW DUPLEX WALL MOUNTED POWER RECEPTACLE 15A @ 110 A.R.P. UNLESS NOTED OTHERWISE ON PLAN
8	NEW DUPLEX WALL MOUNTED POWER RECEPTACLE 15A @ 110 A.R.P. UNLESS NOTED OTHERWISE ON PLAN
9	FLUSHMOUNT 2000 GAGEWAY METAL RACEWAY, LENGTH & RECEPTACLE SPECIES AS SHOWN ON PLAN
10	NEW DUPLEX POWER RECEPTACLE ON FLUSHMOUNT 2000 GAGEWAY RACEWAY
11	NEW DUPLEX POWER RECEPTACLE ON FLUSHMOUNT 2000 GAGEWAY RACEWAY FOR CBT MONITORS, INSTALL ON TRAILING CABLE SPIND, KEEP OUT RECEPTACLE 2 ON INDIVIDUAL CIRCUITS
12	SPECIAL PURPOSE POWER RECEPTACLE 2000 GAGEWAY THIS SHEET
13	WALL MOUNTED SIGNAL OUTLET SEE SCHEDULE THIS SHEET
14	PROVIDE BUSHED COVER PLATE
15	SIGNAL CABLE THRU RAISED FLOOR, PROVIDE FLOOR HEAD OR GEOMETRIC IN RAISED FLOOR PANEL FOR CABLES
16	QUADRUPLER RECEPTACLE 15A INSTALL IN STANDARD ACCESS FLOOR HEAD ON RAISED ACCESS FLOOR
17	QUADRUPLER RECEPTACLE 15A SURFACE MOUNTED TO CONCRETE SLAB BELOW RAISED ACCESS FLOOR
18	SPACE NO. 12
19	NEW TELEPHONE WALL OUTLET INSTALL AT 1'-0" A.R.P. UNLESS NOTED OTHERWISE ON PLAN
20	NEW WALL MOUNTED TELEPHONE INSTRUMENT, INSTALL AT 4'-0" A.R.P.
21	NEW TELEPHONE FLOOR OUTLET INSTALL STANDARD TELEPHONE FLOOR HEAD OR GEOMETRIC ON RAISED ACCESS FLOOR
22	NEW WALL MOUNTED TELEPHONE SIGNAL OUTLET, PROVIDE BUSHED COVER PLATE SEE SIGNAL OUTLET SCHEDULE ABOVE

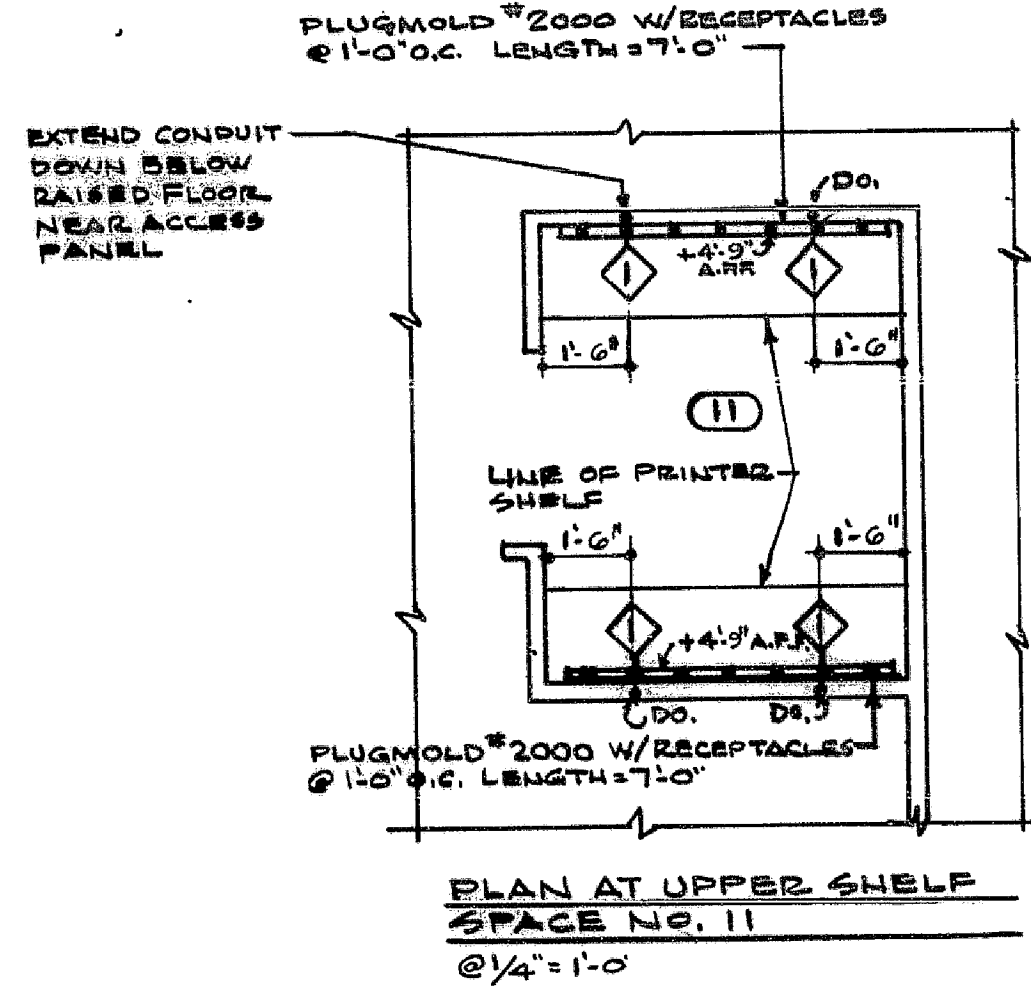

NOTE ELECTRICAL CONTRACTOR
GEOMETRIC IN RAISED FLOOR PANELS FOR WIRING TO TRADING DESK SHALL BE PROVIDED BY RAISED ACCESS FLOOR CONTRACTOR. INSTALLATION BY ELECTRICAL CONTRACTOR. SEE DRAWING 105P-5 FOR APPROXIMATE GEOMETRIC LOCATIONS.

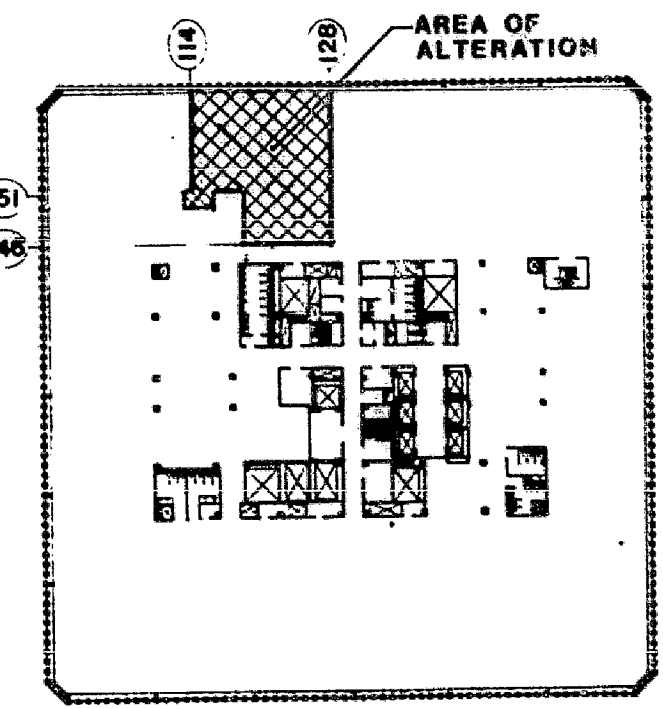


KEY PLAN
1/64" = 1'-0"




PHASE

P

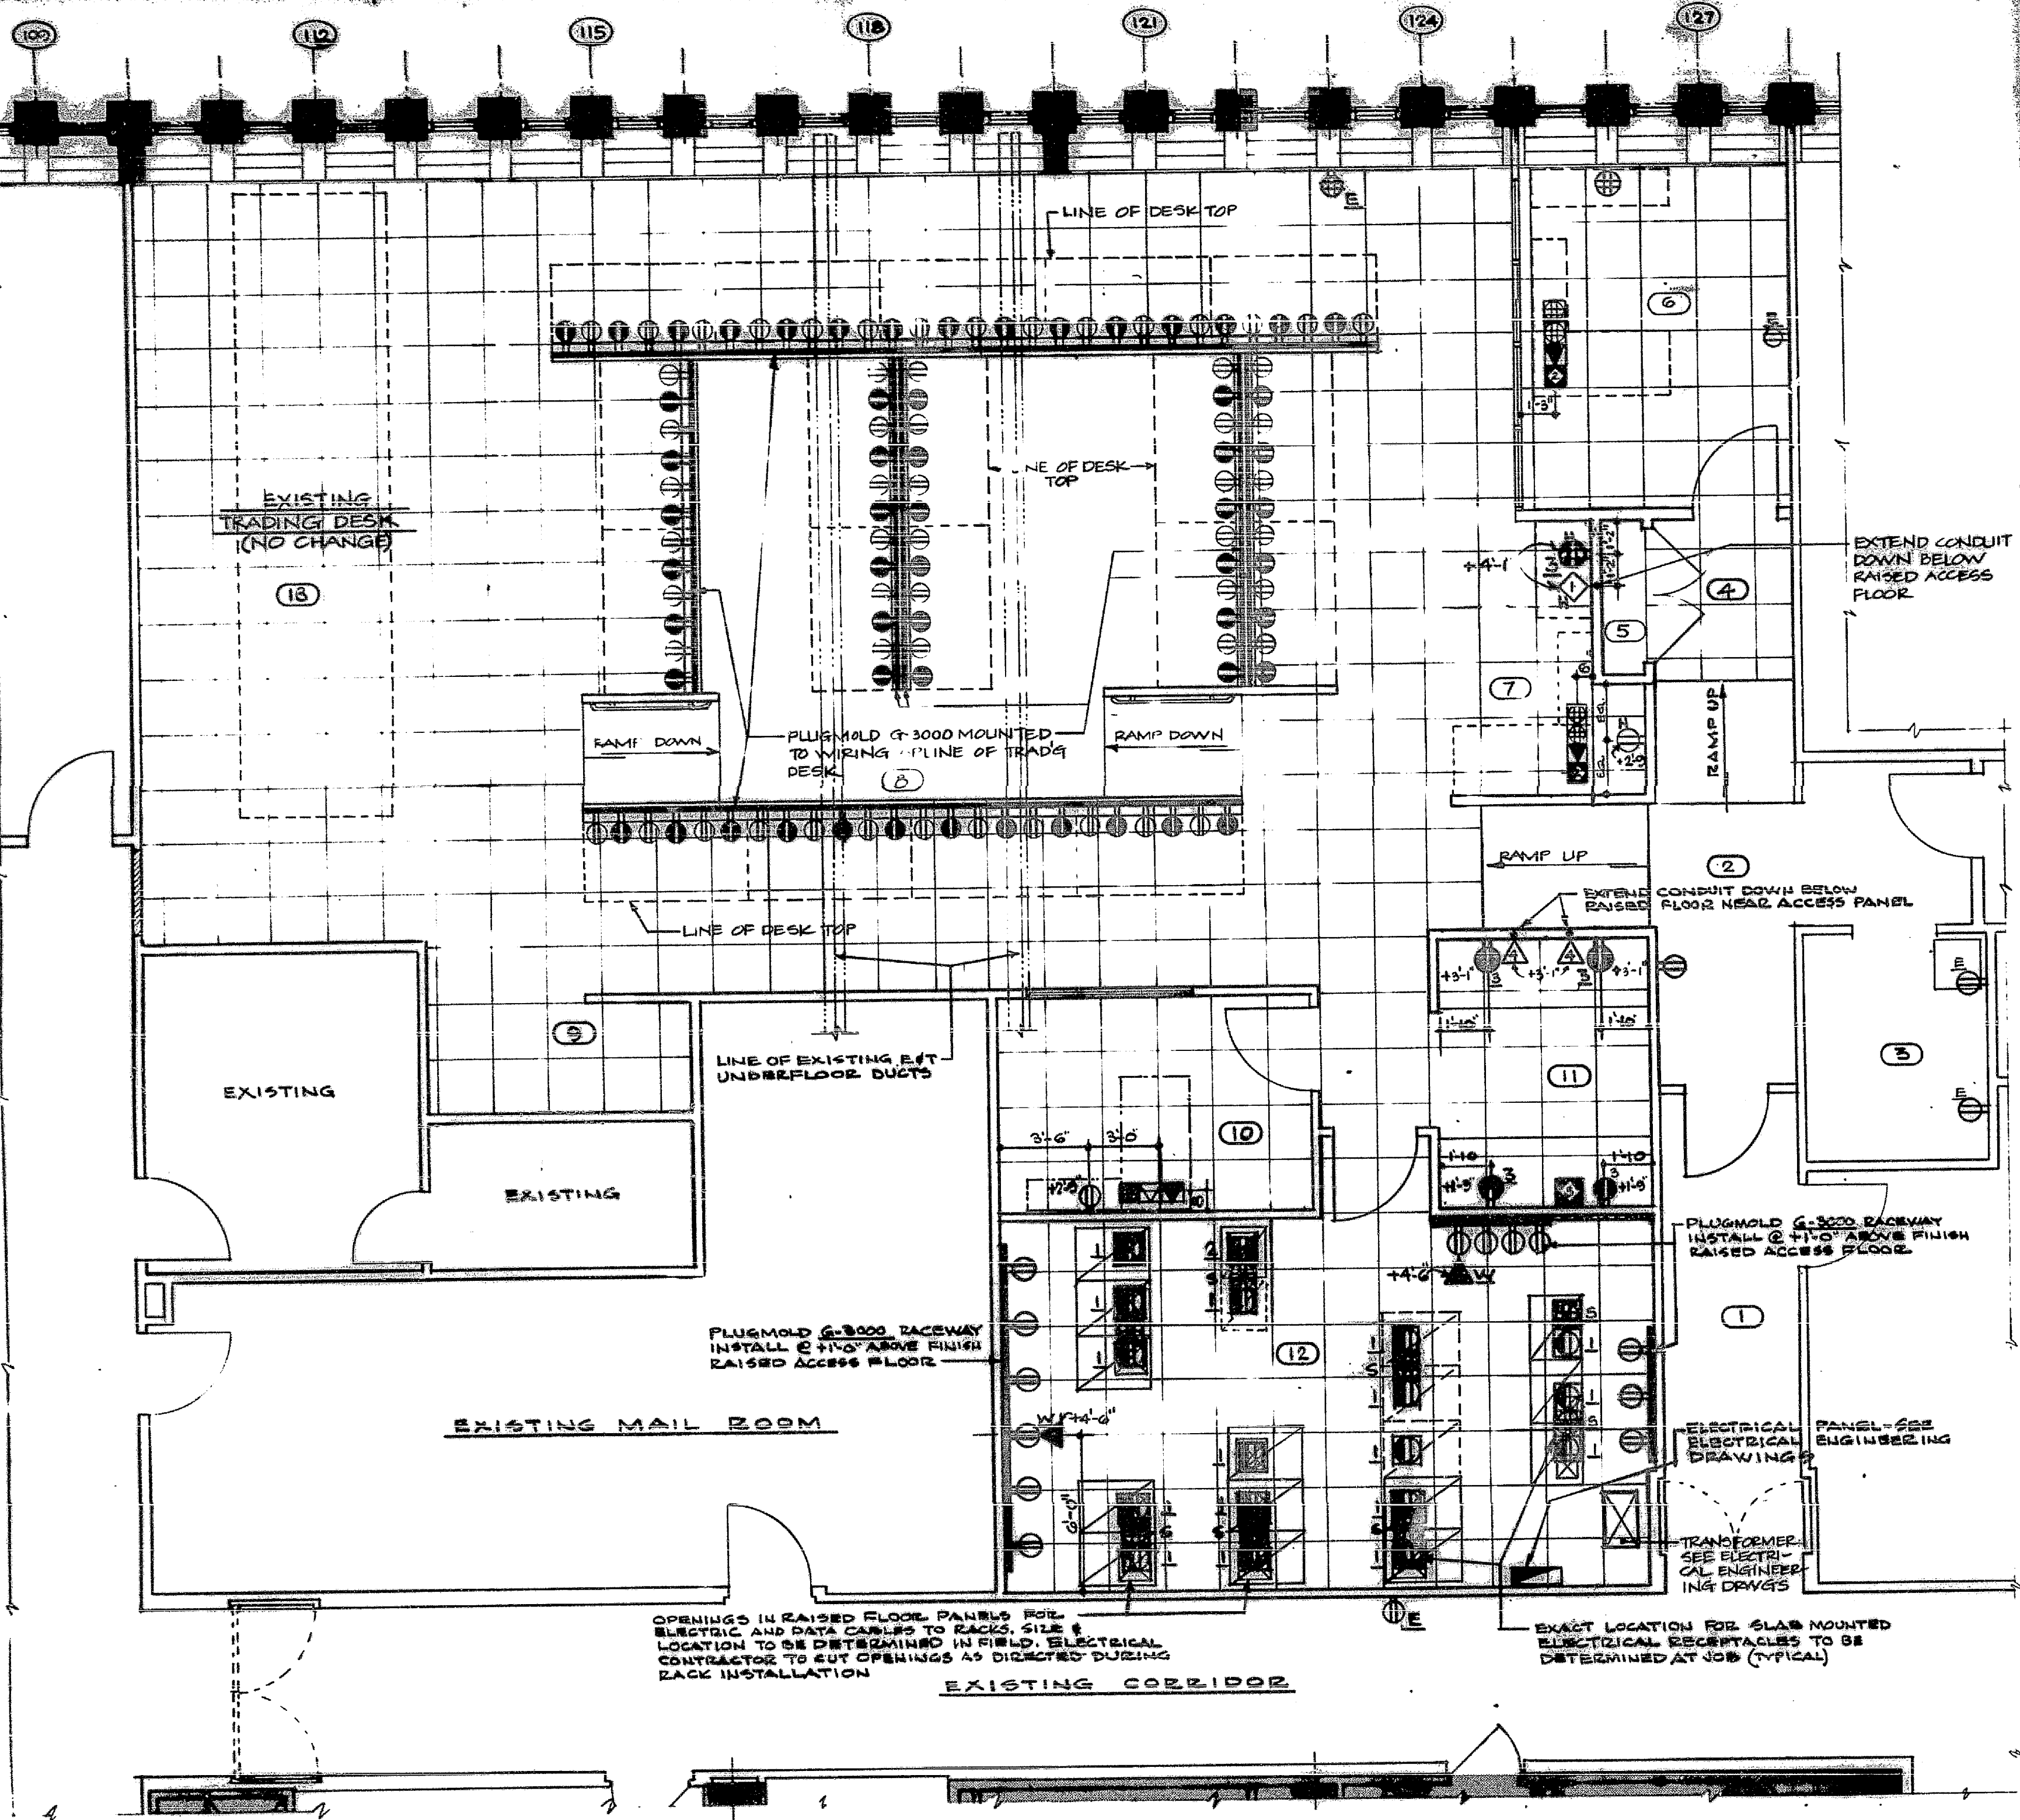T.A.A. NO. W91051



PART PLAN 105TH FLOOR
1/4" = 1'-0"

SCHEDULE OF SPECIAL PURPOSE ELECTRICAL RECEPTACLES											
SYMBOL	VOLTS	AMPS	PHASE	DESCRIPTION OR USE	REMARKS	SYMBOL	VOLTS	AMPS	PHASE	DESCRIPTION OR USE	REMARKS
 1	120	2 20A	1	ELECTRONIC RACK CABINETS SPACE NO. 8	EACH DUPLEX RECEPTACLE SHALL BE WIRING AS (2) 20A SEPARATE CIRCUITS, SURFACE MOUNTED ON SLAB BELOW RAISED ACCESS FLOOR						
 2	120	15A	1	LAUSEZ TELEPHONE RECORDING/PLAYBACK CABINET							
 3	120	20A	1	LARGE JET PRINTERS & FAX MACHINES							

DRAWING NUMBER
A. 105
CANTOR, FITZGERALD
105P 7

DRAWING NUMBER
A. 105
CANTOR, FITZGERALD
105P 7

DRAWING NUMBER
A. 105
CANTOR, FITZGERALD
105P 7

DRAWING NUMBER
A. 105
CANTOR, FITZGERALD
105P 7